



# Westover Companies

724 W. Lancaster Avenue Wayne, PA

01/19/23

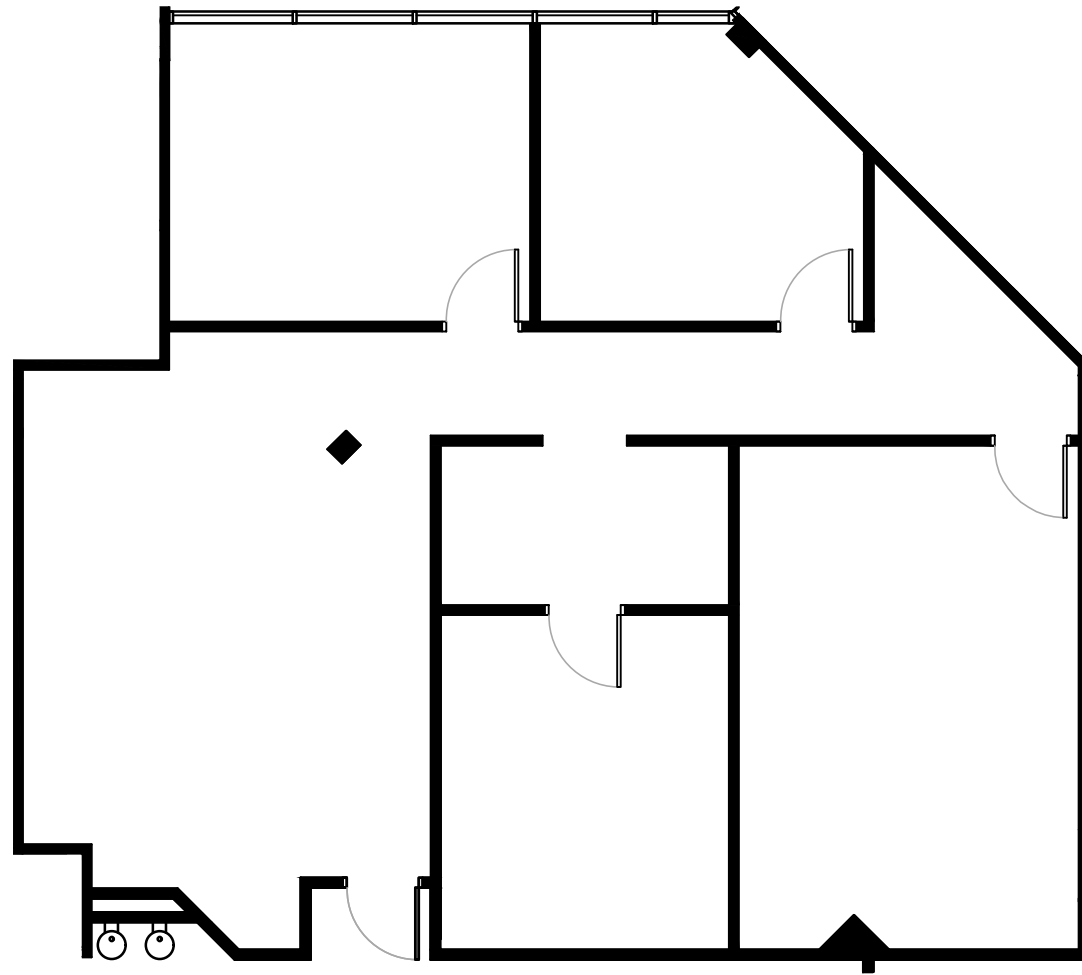

**Record Drawing - Second Floor**  
Scale: 1/8" = 1'-0"

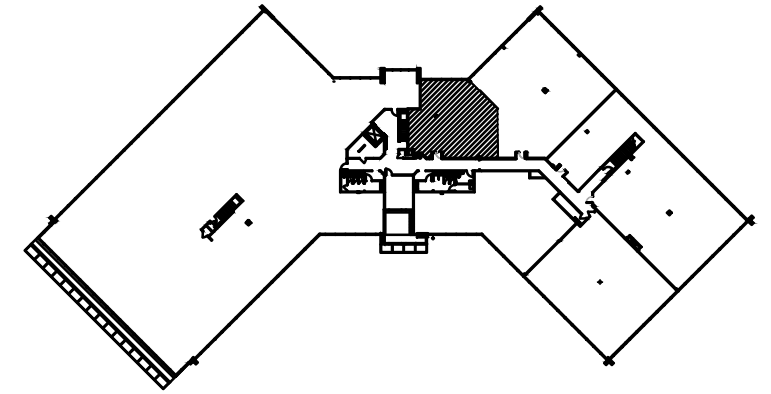

**Key Plan**  
Not to Scale

PRELIMINARY - NOT FOR CONSTRUCTION  
THIS DRAWING DOES NOT REFLECT THE GUIDELINES SET FORTH BY THE WORLD HEALTH ORGANIZATION AND CENTERS FOR DISEASE CONTROL OR OTHER GOVERNMENTAL AGENCY GUIDELINES RELATED TO COVID-19