



Westover Management Company

Devon Square 1
724 W. Lancaster Avenue, Wayne, PA 19087
06/06/24

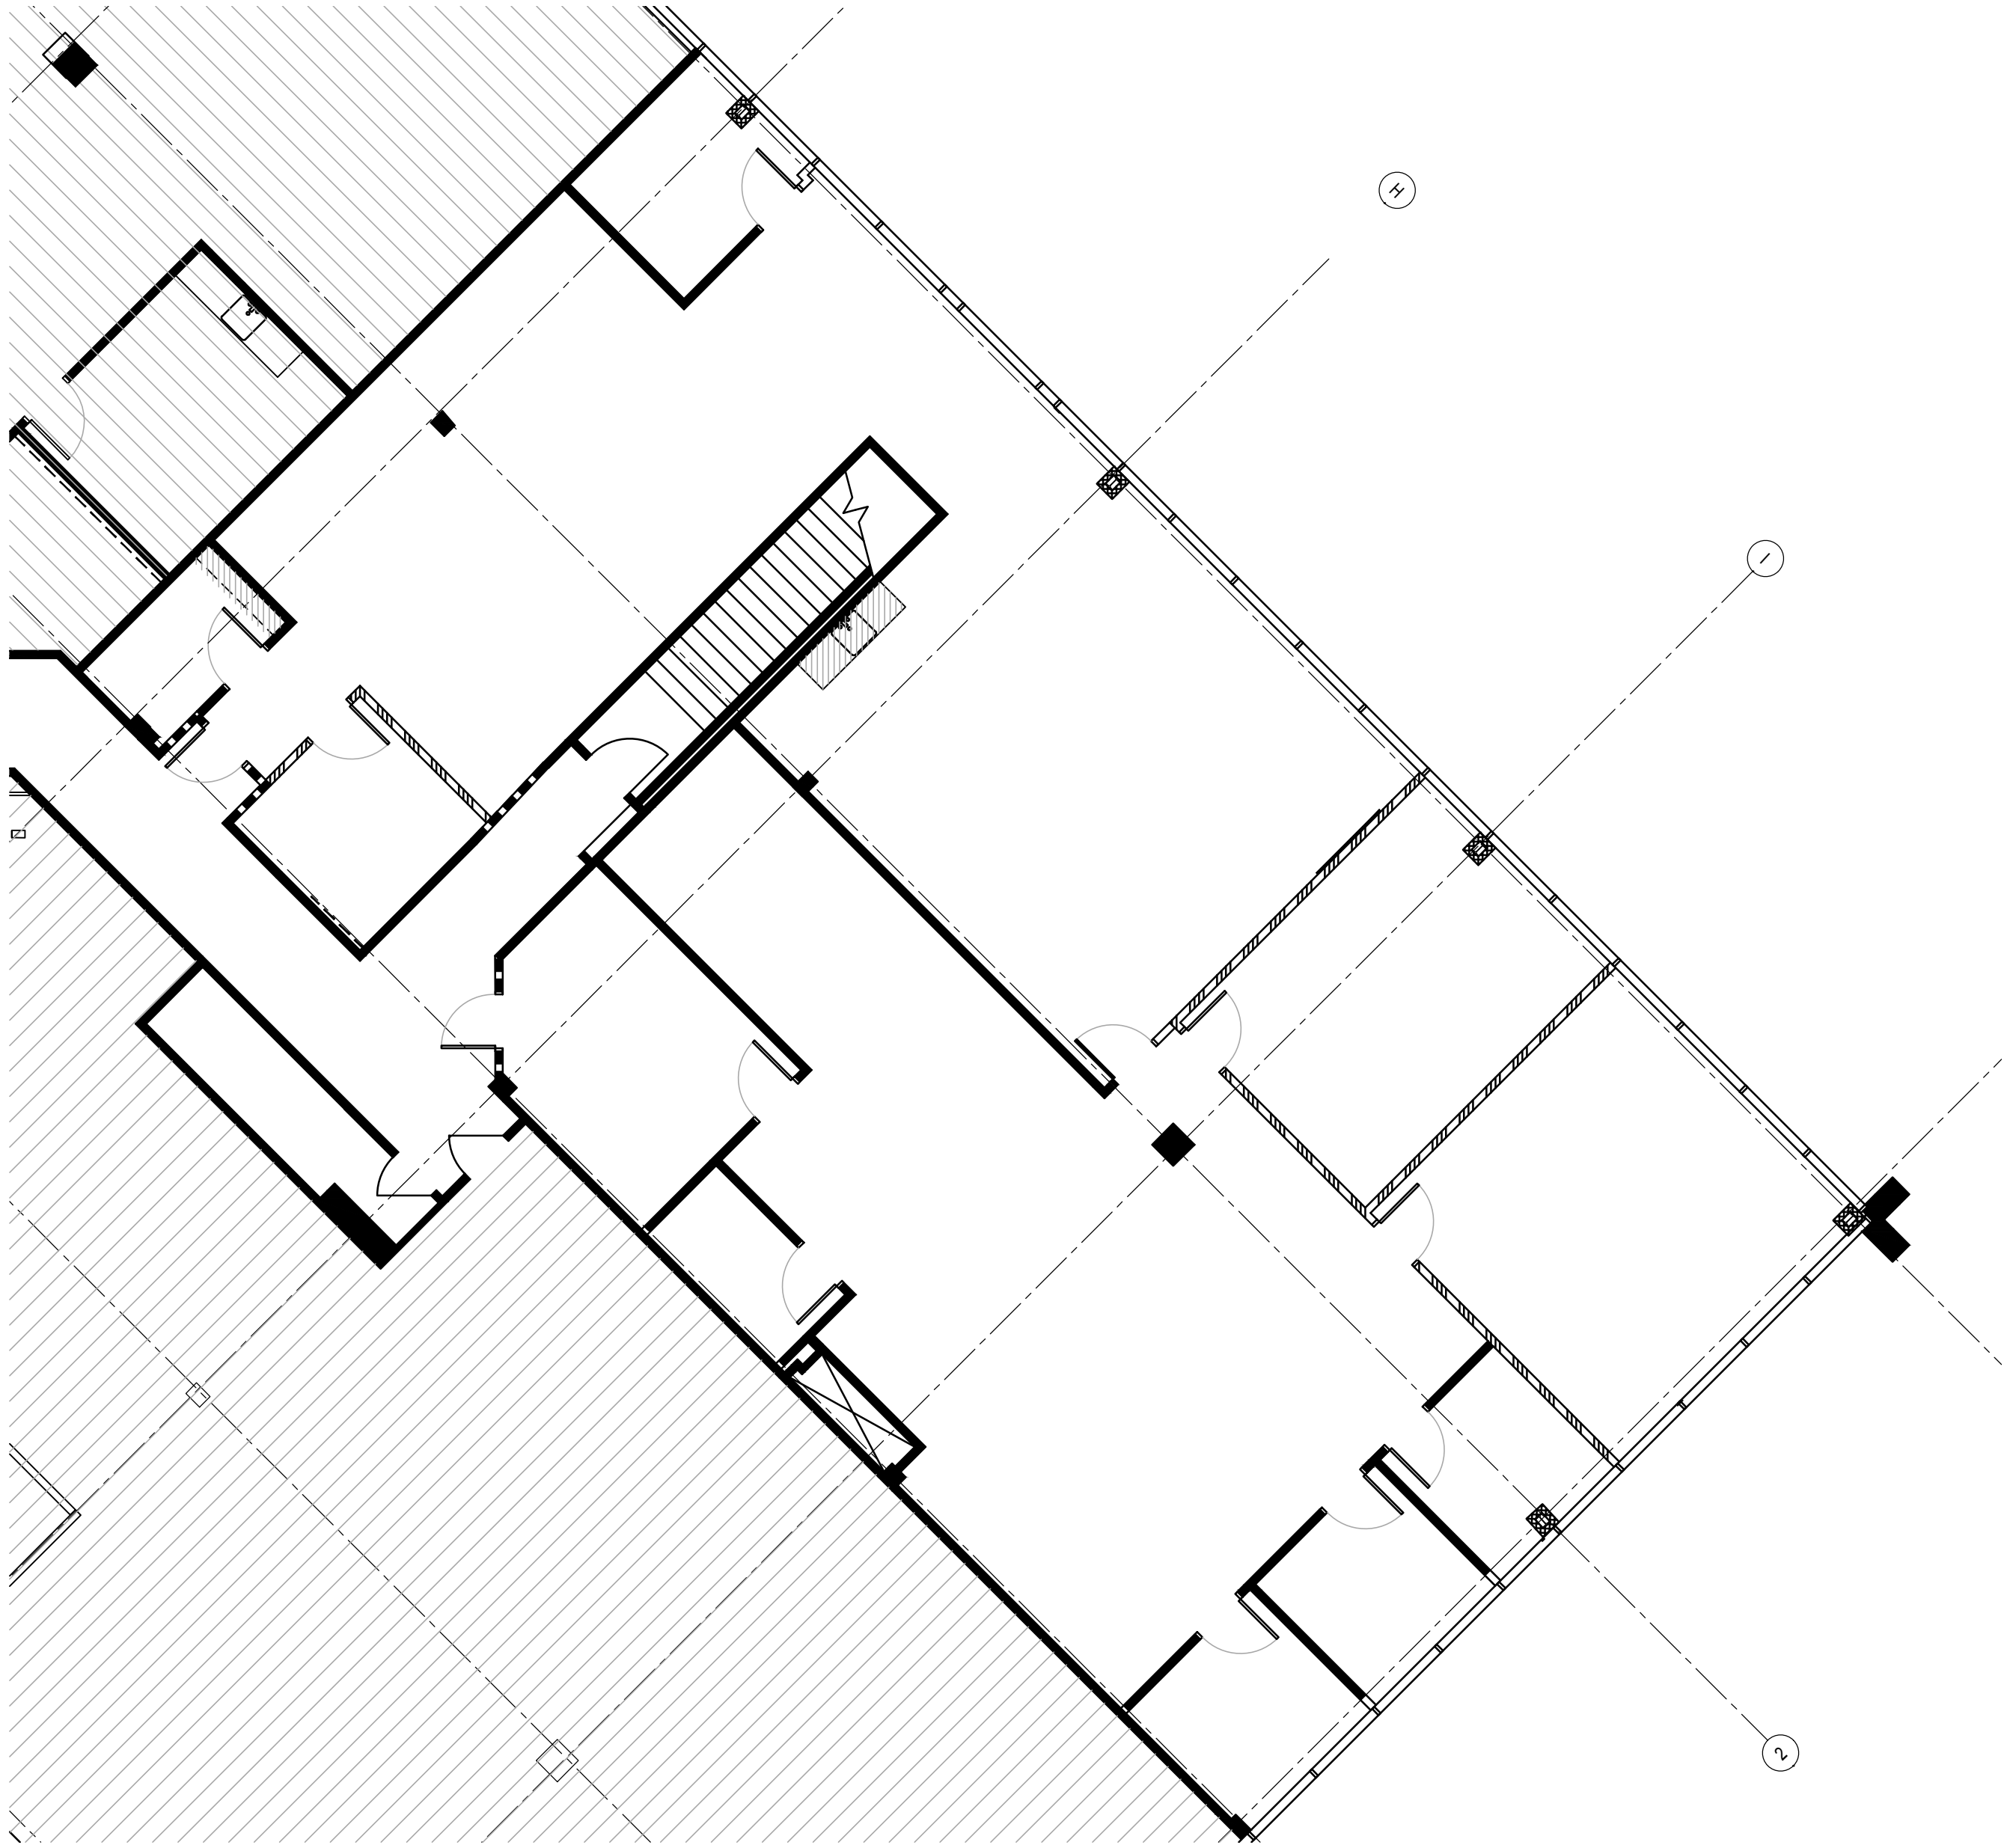

Suite 220 - Record Drawing

Scale: 1/8" = 1'-0"

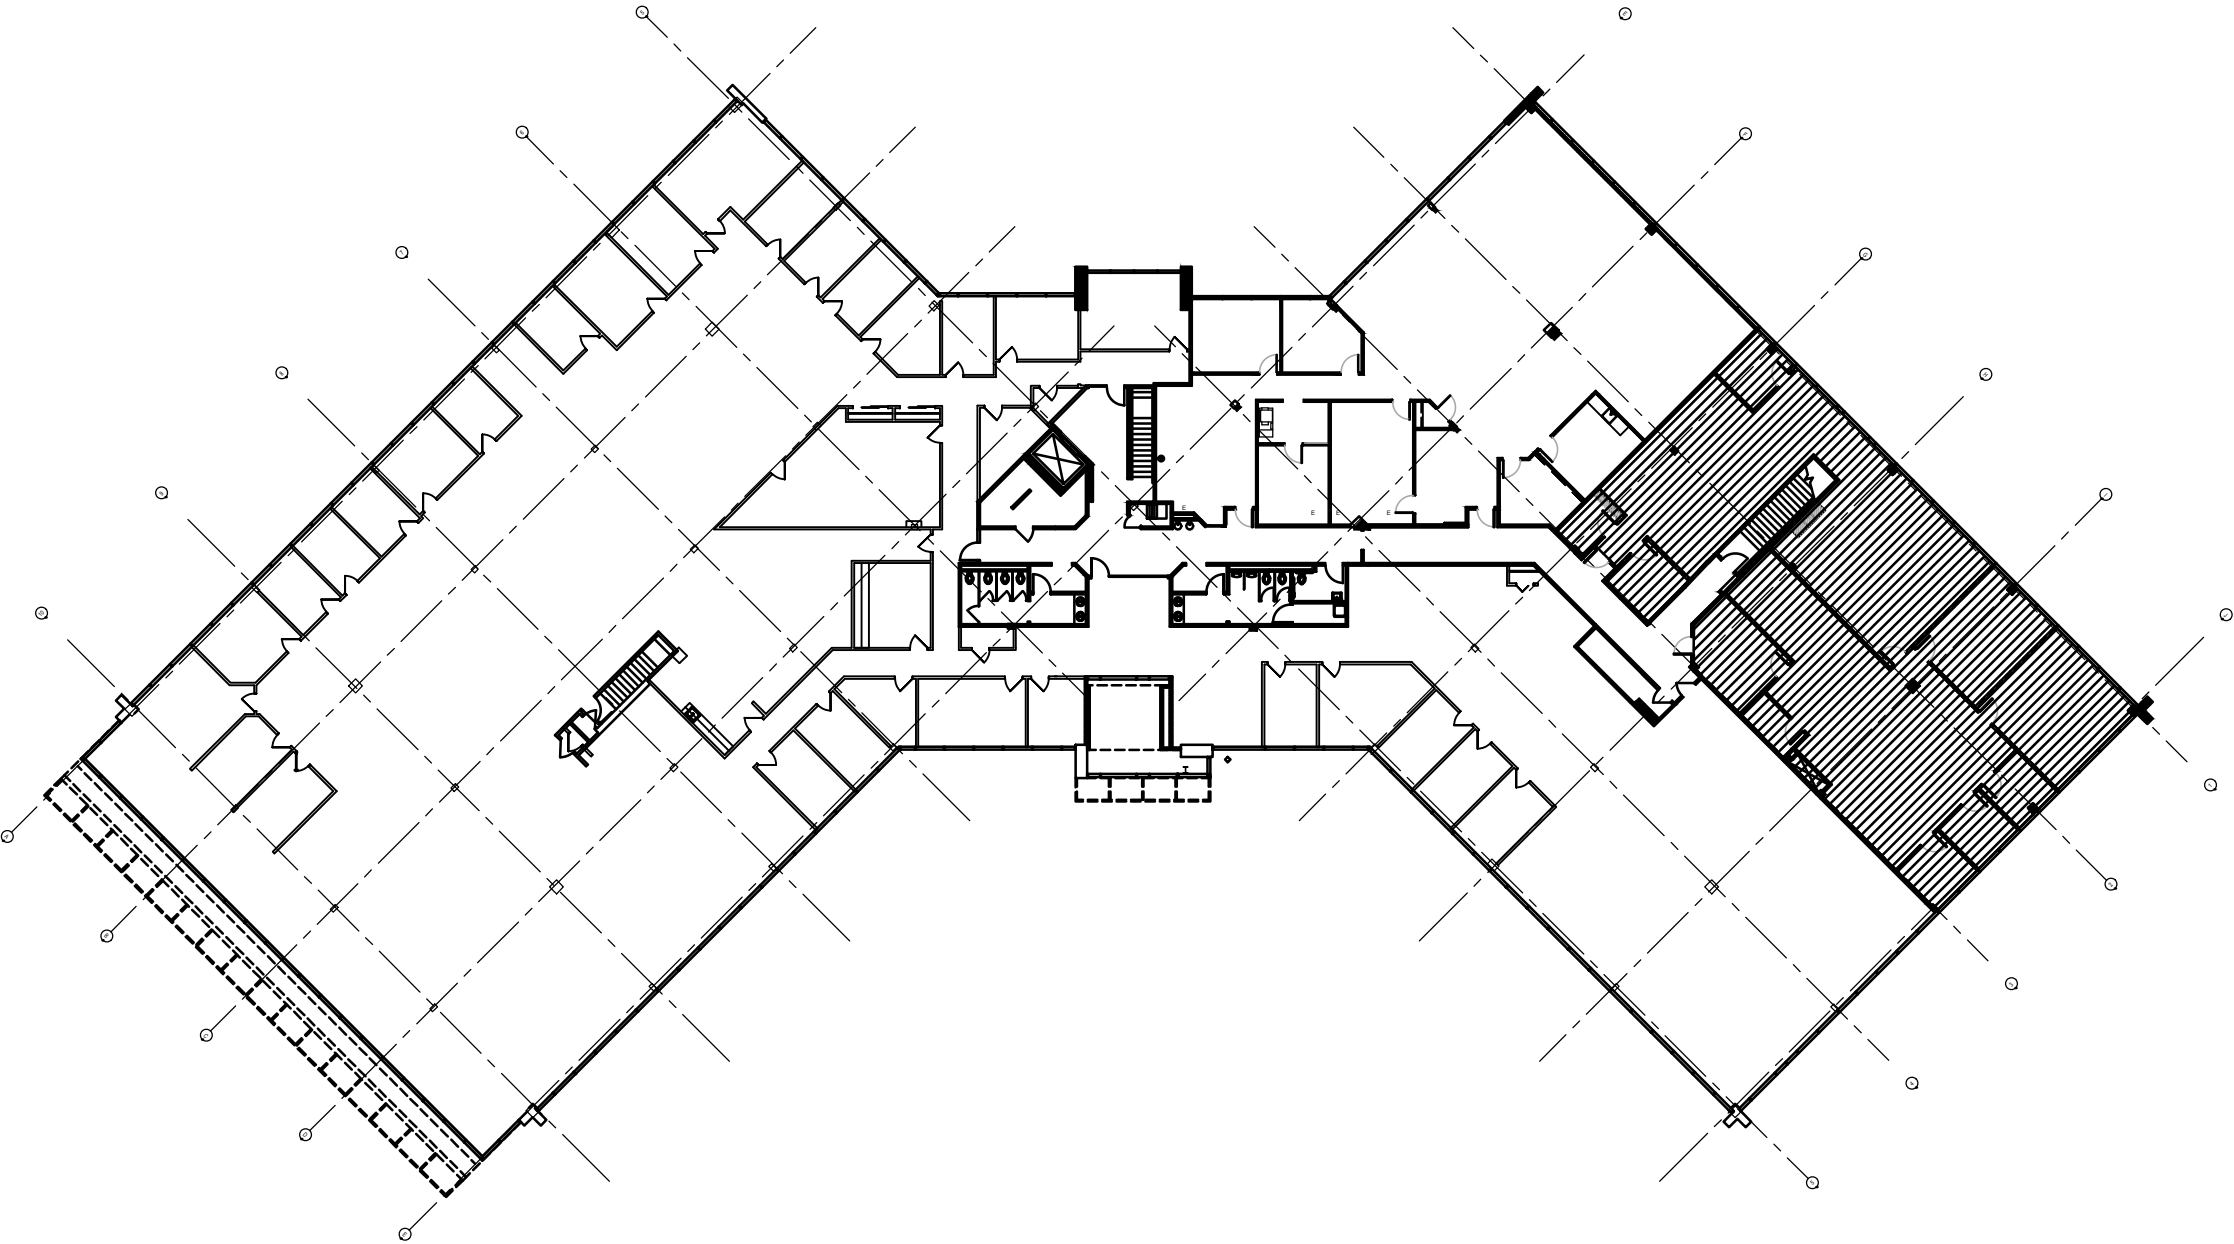

Key Plan

NTS